



- NOTE
1. ALL LEVELS ARE IN TERMS OF HAWKES BAY DATUM (MSL = +10m)
 2. CO-ORDINATES ARE IN TERMS OF GEODETIC 1949 TRIG 'A'
700,000mN, 300,000mE
 3. CONTOURS ARE AT 0.25m INTERVALS

- | | |
|------------------|---------------------------------------|
| SERVICES | SERVICES |
| 1. Ⓡ ELECTRICITY | 4. STORMWATER |
| 2. □ TELECOM | 5. TOWN WATER |
| 3. Ⓢ SKY | 6. SEWER (on site treatment by owner) |
- GRAPHIC SCALE
-

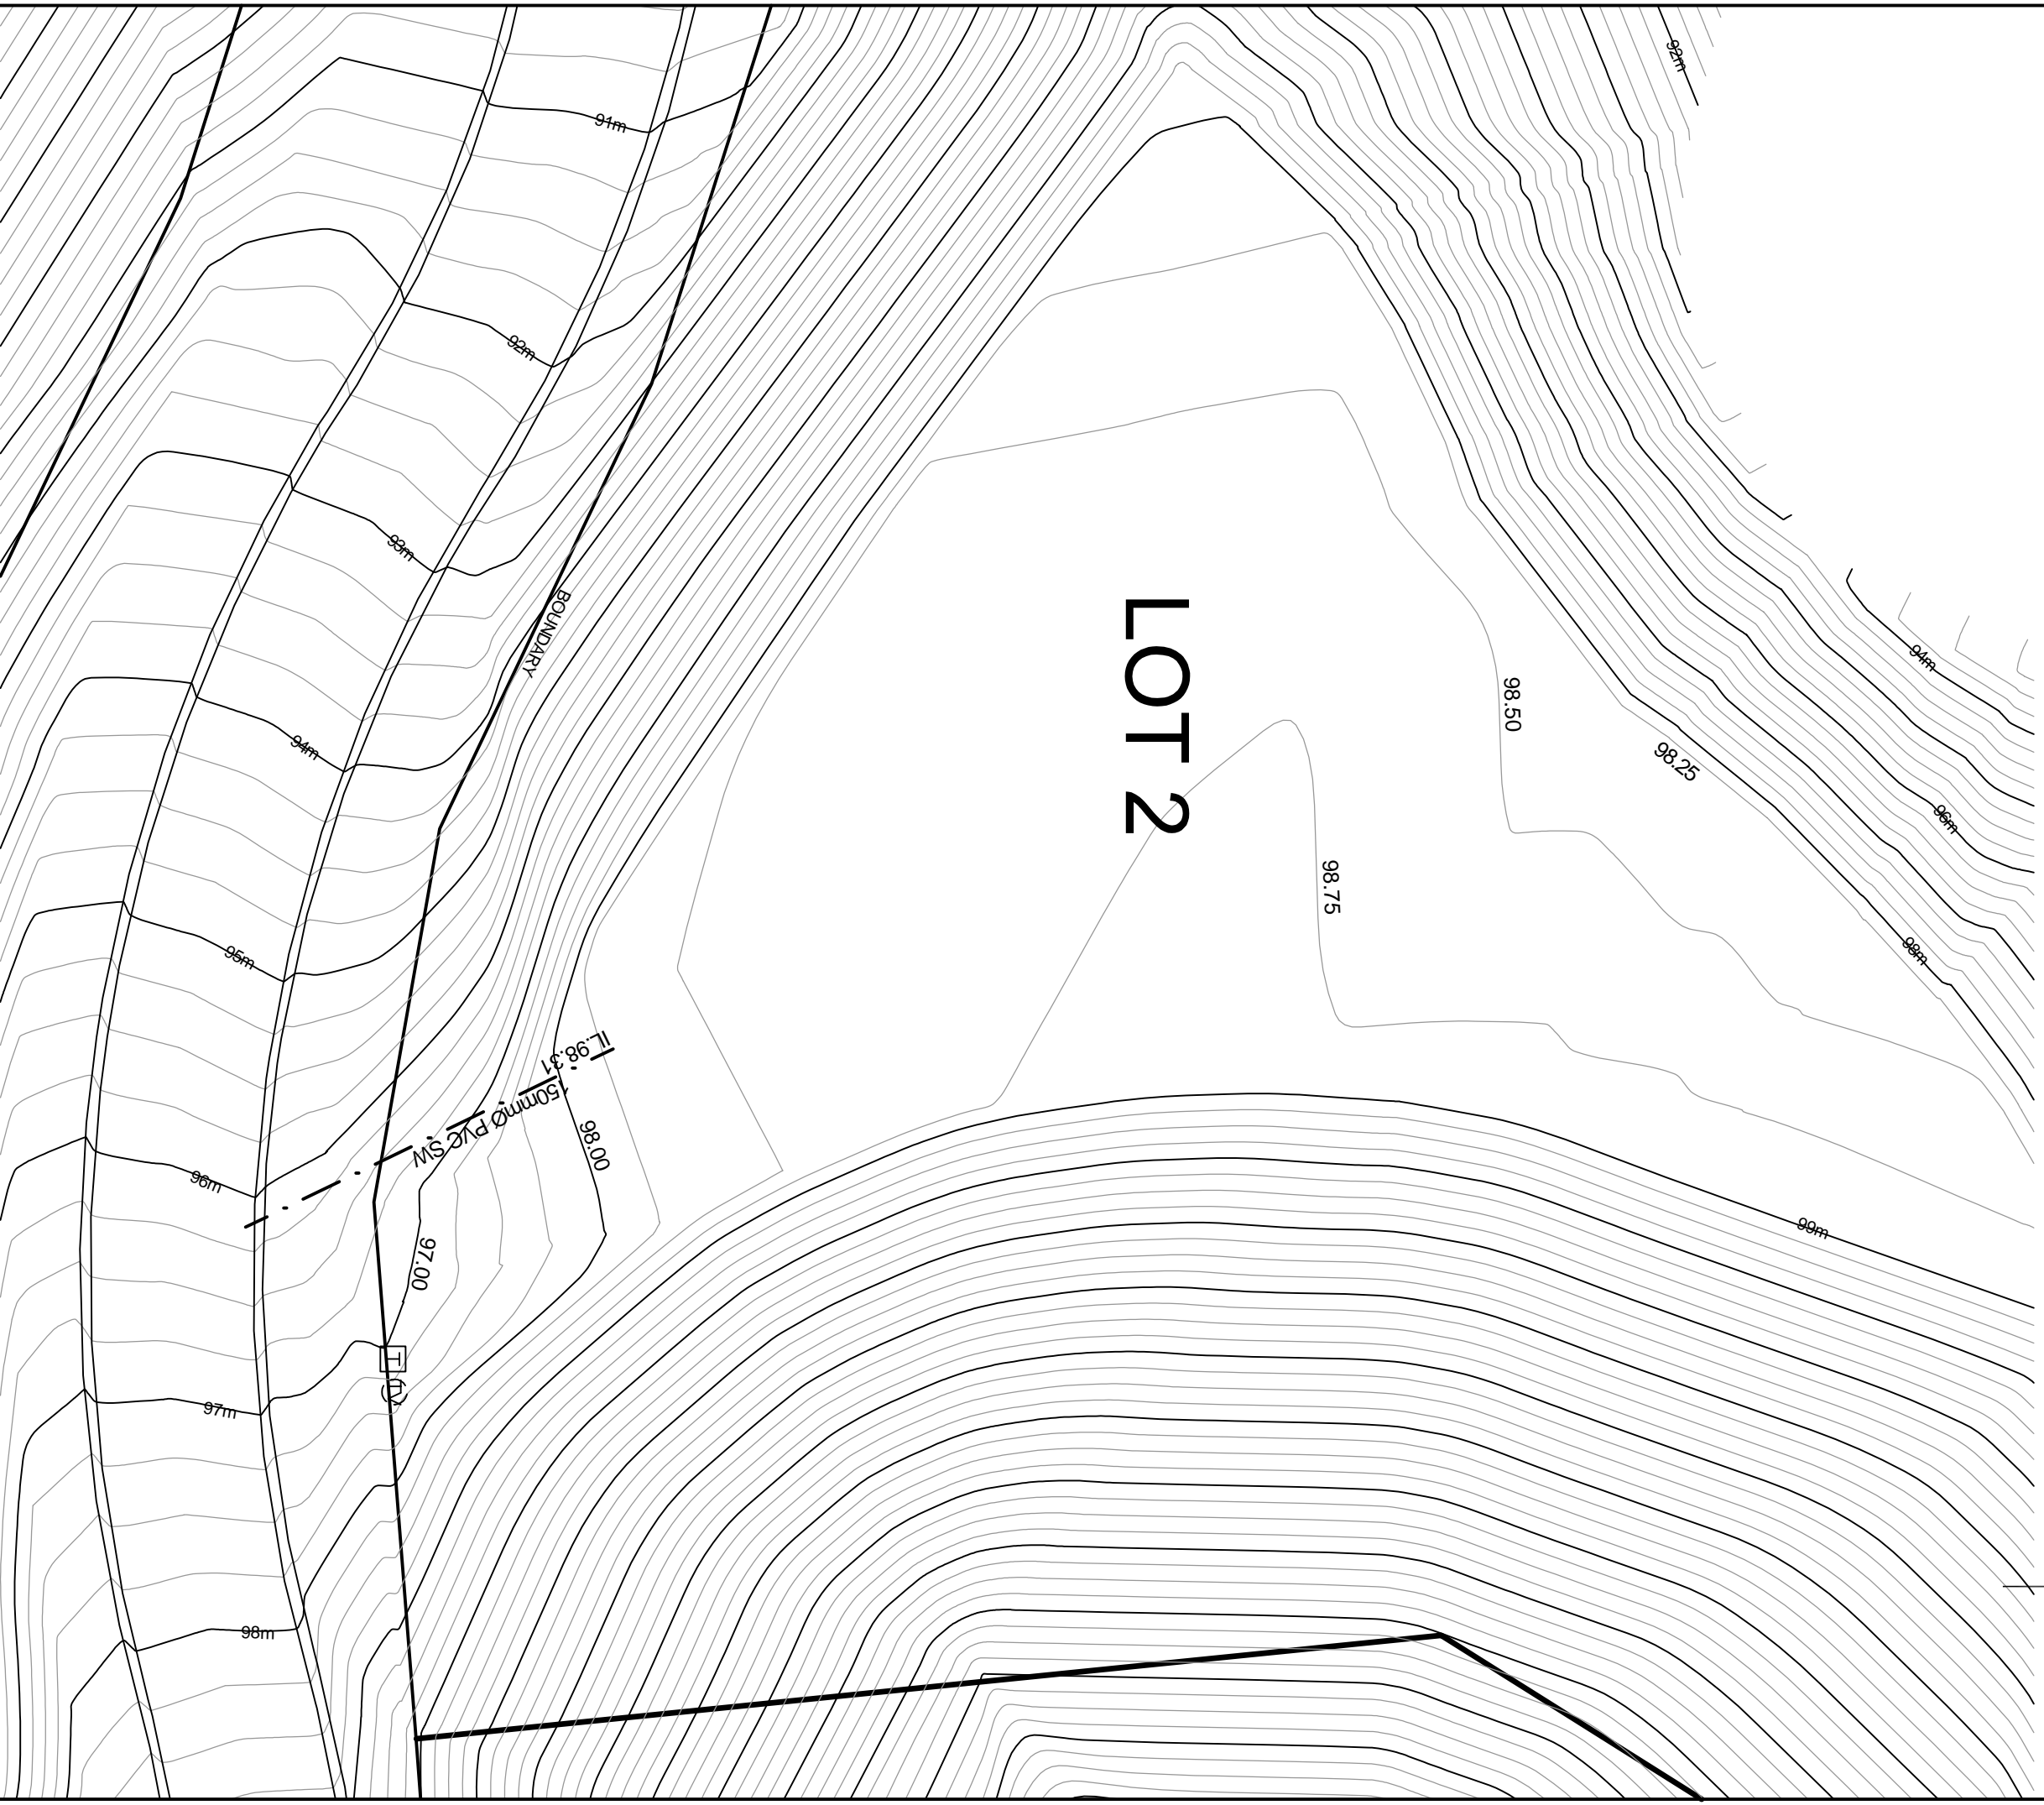

SCALE 1:250

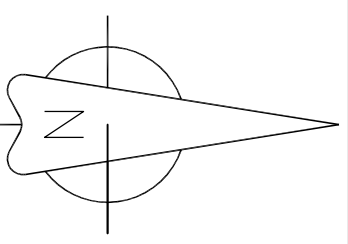

ESK VIEW ROAD, NAPIER
LOT 2
SITE & SERVICES AS-BUILT

