
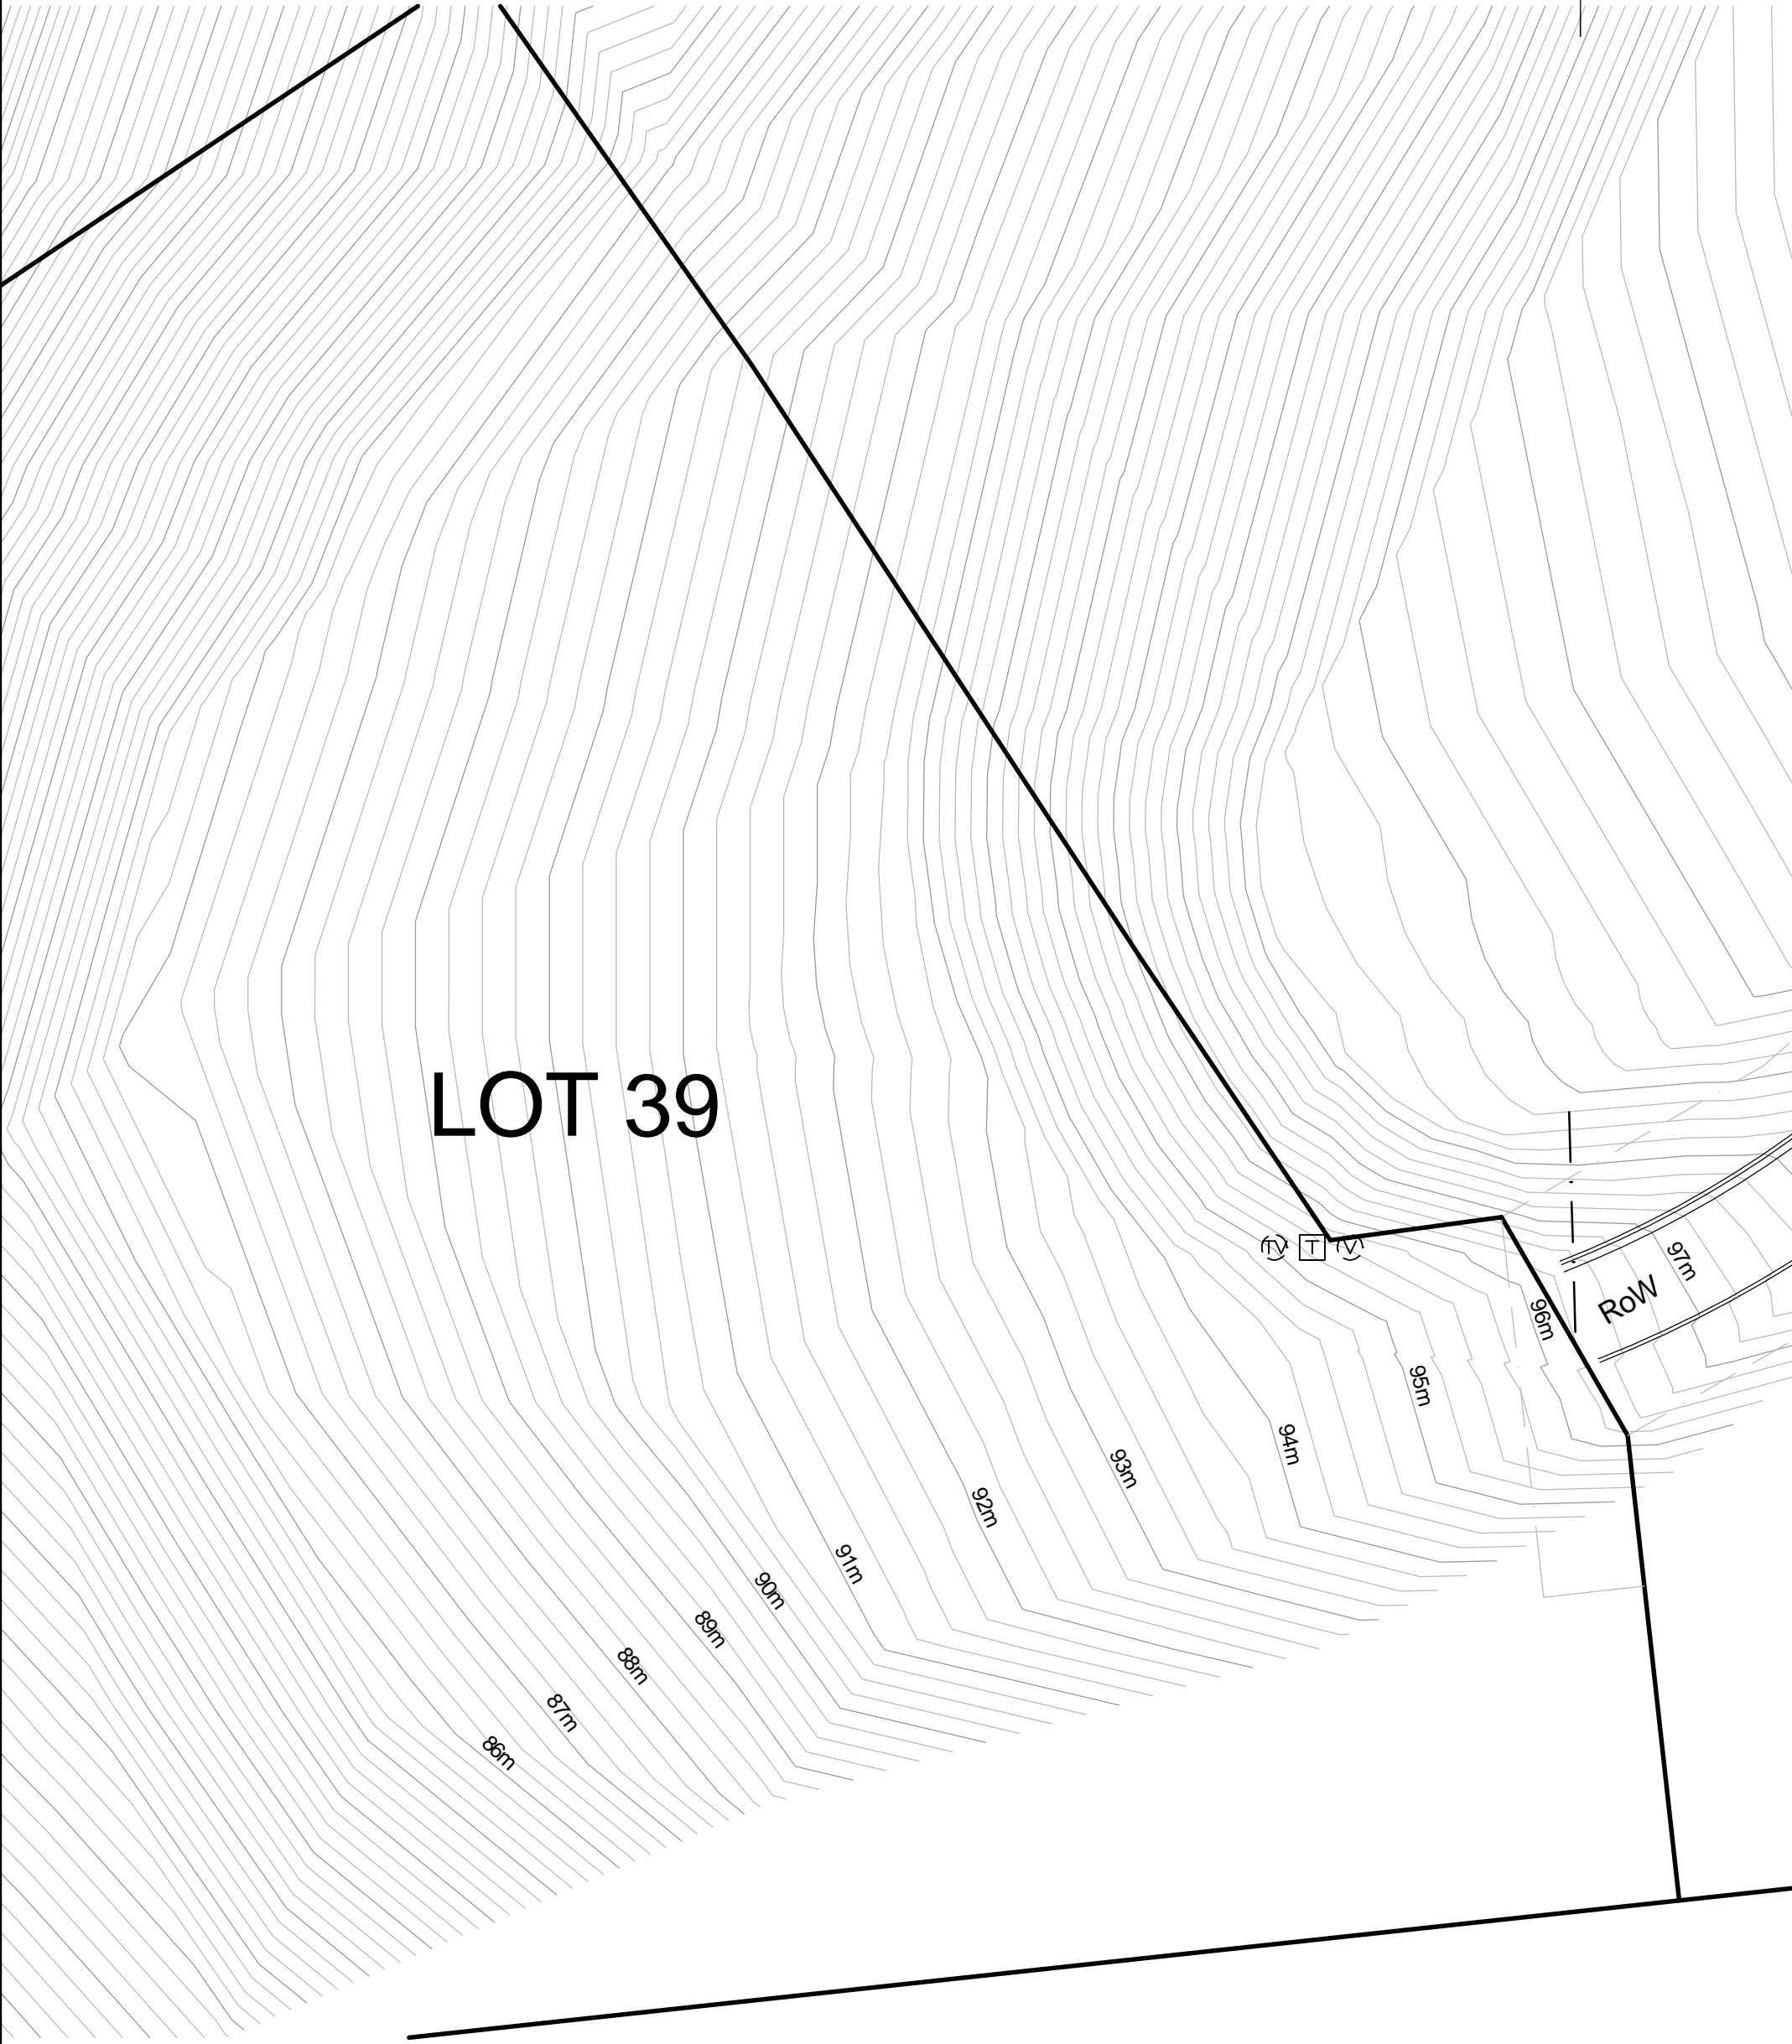


NOTE

- 1. ALL LEVELS ARE IN TERMS OF HAWKES BAY DATUM (MSL = +10m)
- 2. CO-ORDINATES ARE IN TERMS OF GEODETIC 1949 TRIG 'A'  
700,000mN, 300,000mE
- 3. CONTOURS ARE AT 0.25m INTERVALS

UNDERGROUND SERVICES

- 1. Ⓧ ELECTRICITY
  - 2. □ TELECOM
  - 3. Ⓧ SKY
  - 4. STORMWATER
  - 5. TOWN WATER
  - 6. SEWER (on site treatment by owner)
- 5m 0m 5m 10m 15m 20m  
GRAPHIC SCALE

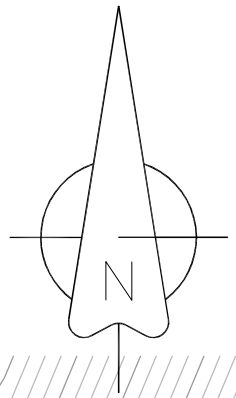

SCALE 1:250



ESK VIEW ROAD, NAPIER  
**LOT 39**  
 SITE & SERVICES AS-BUILT

