
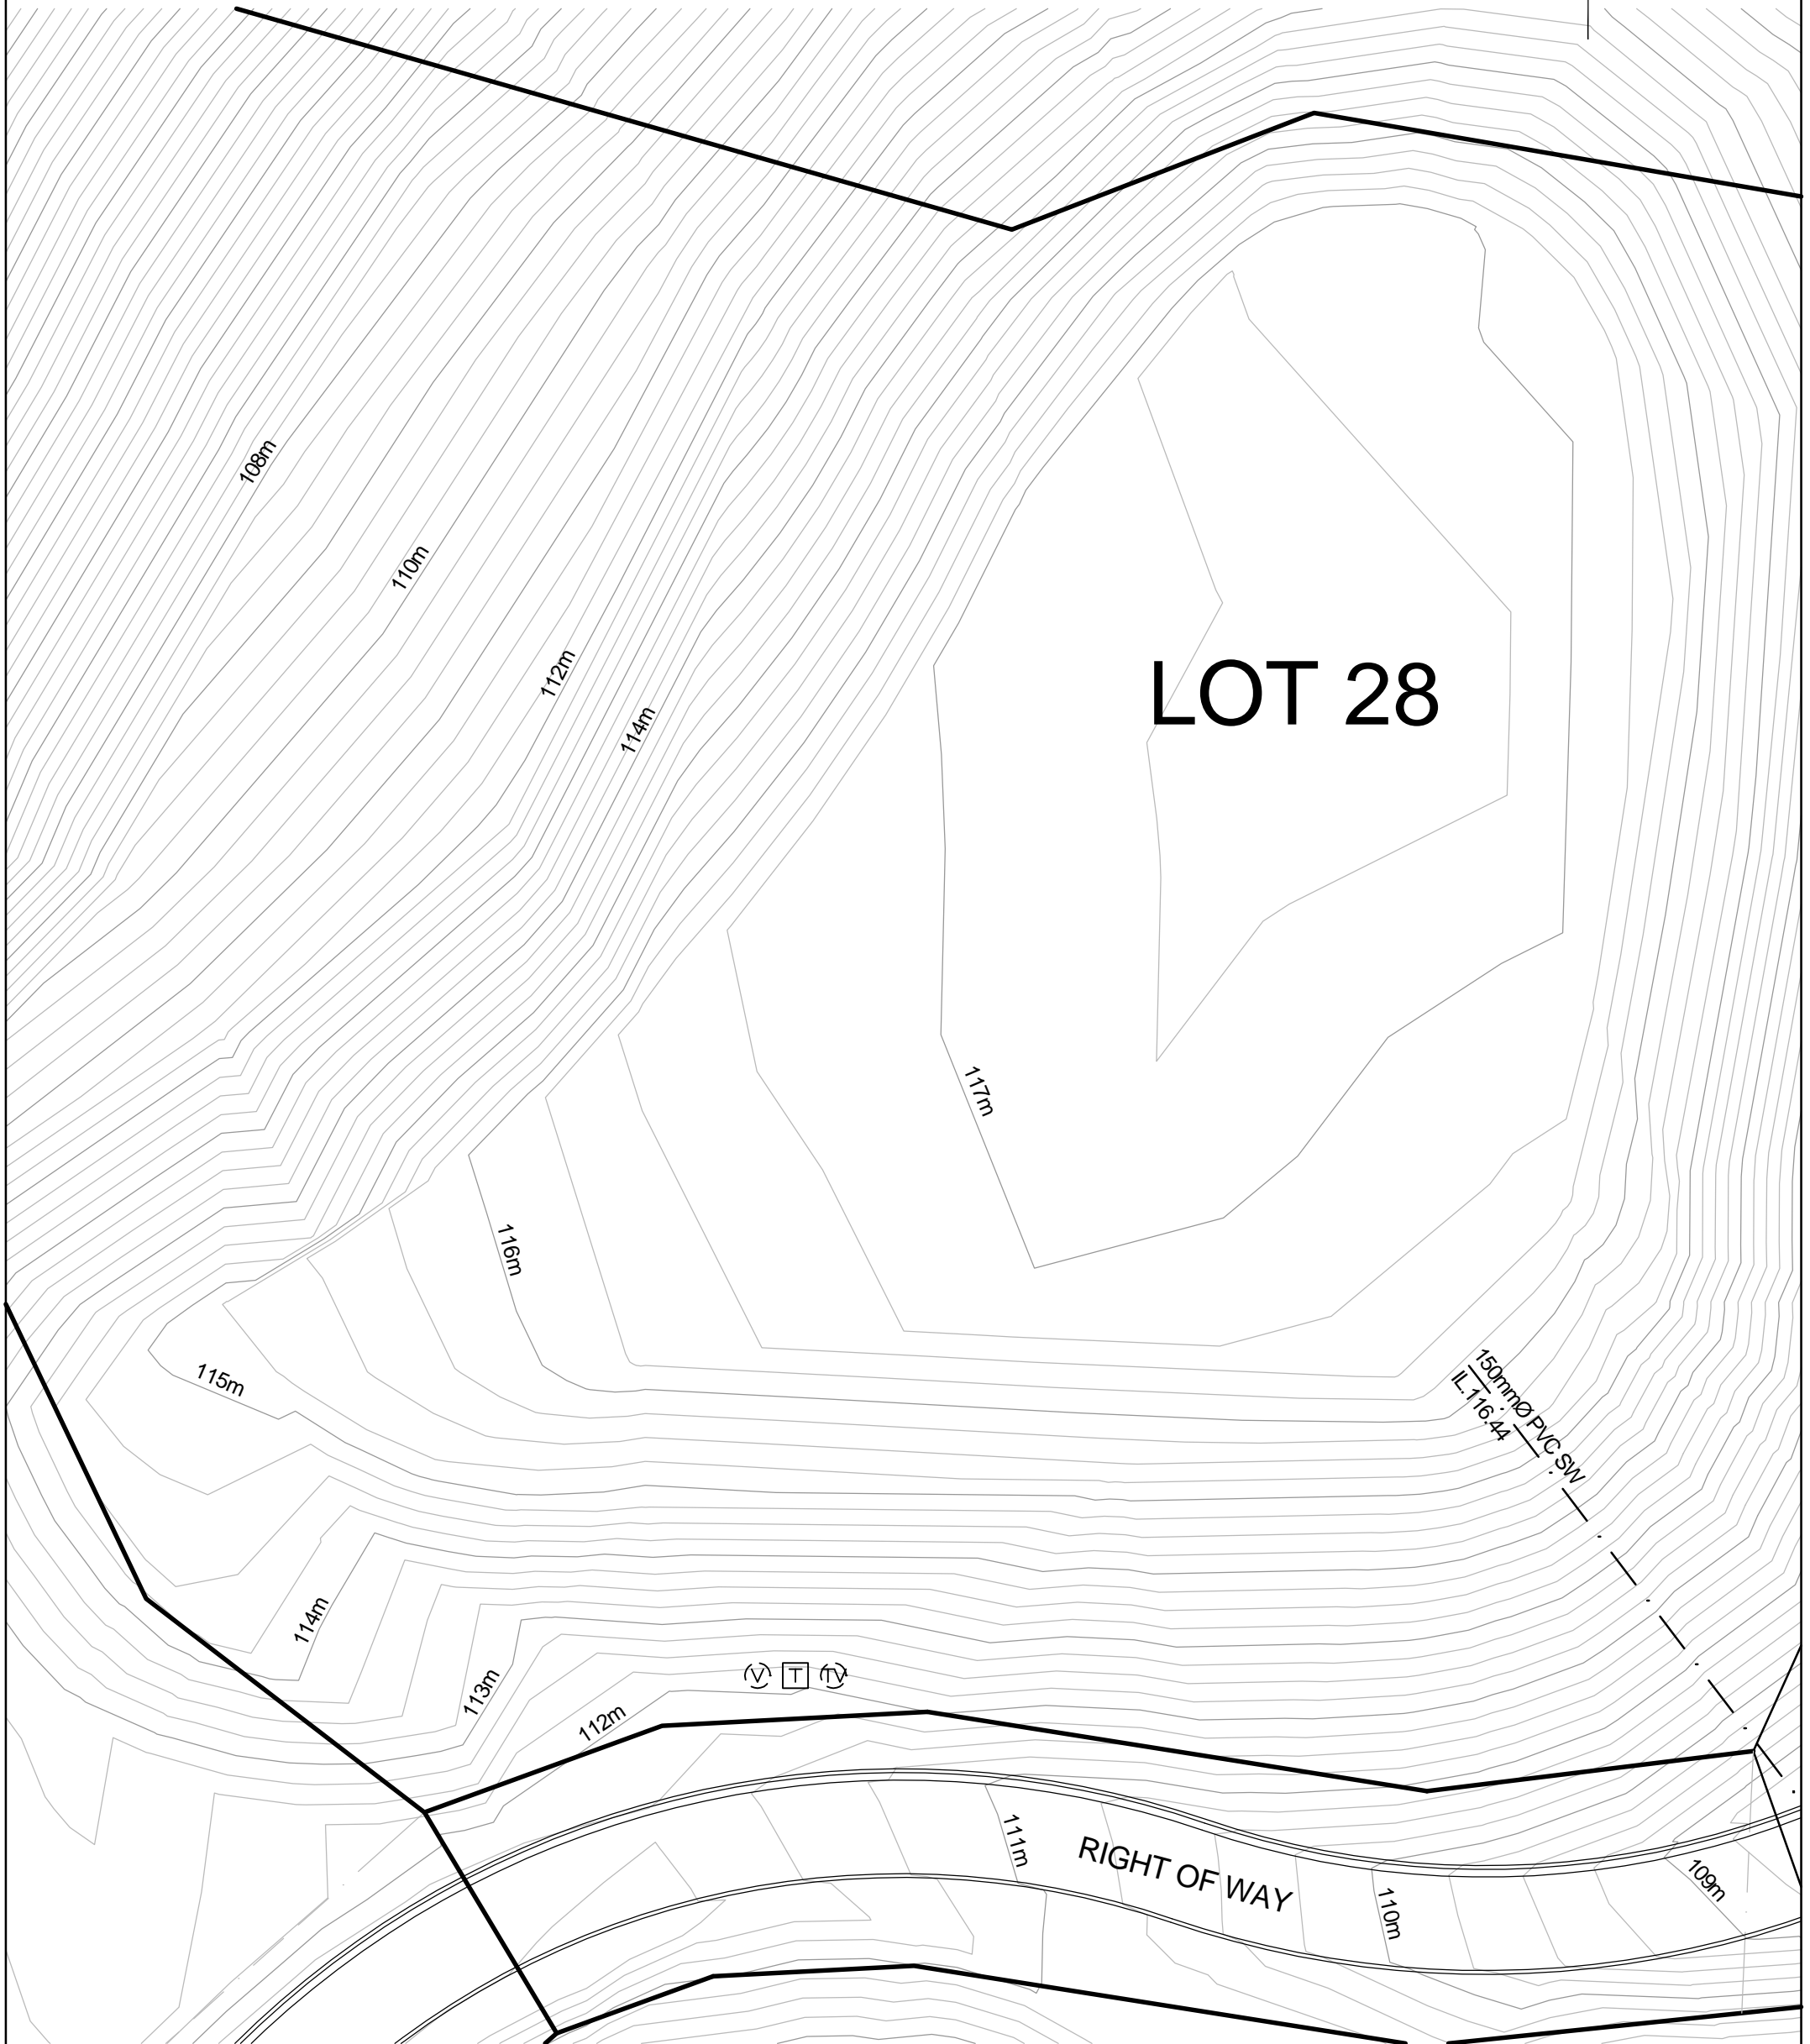
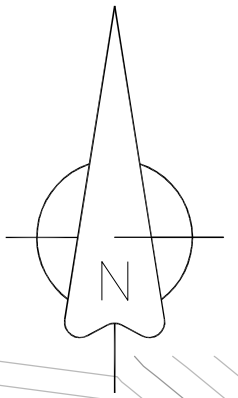


NOTE

- 1. ALL LEVELS ARE IN TERMS OF HAWKES BAY DATUM (MSL = +10m)
- 2. CO-ORDINATES ARE IN TERMS OF GEODETIC 1949 TRIG 'A' 700,000mN, 300,000mE
- 3. CONTOURS ARE AT 0.25m INTERVALS

UNDERGROUND SERVICES

- 1. Ⓧ ELECTRICITY
- 2. □ TELECOM
- 3. Ⓧ SKY
- 4. STORMWATER
- 5. TOWN WATER
- 6. SEWER (on site treatment by owner)

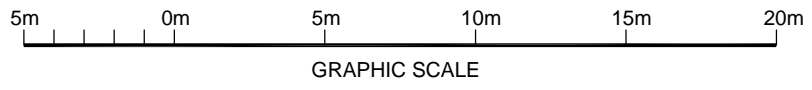

SCALE 1:250



ESK VIEW ROAD, NAPIER
LOT 28
 SITE & SERVICES AS-BUILT

